




COLUMN SCHEDULE

COLUMN NUMBER	REQD	1	2	3	4	5	6	7	8	9	10	11	12	13	14	15	16	17
33	4	3	2	1	1	1	1	1	1	1	1	1	1	1	1	1	1	1

BEAM SCHEDULE

MARK	SIZE	TOP	BOTT.	NO. SPACING EACH END	REMARKS
B-1	10 x 10	2-#5	2-#7	14	5-#6 @ 30" @ ENDS
B-2	10 x 20	FROM B-1	ROOM S-1	10	4-#6 @ 5'
B-3	10 x 20	FROM B-1	2-#1	10	3-#6 @ 4' @ ENDS
B-4	10 x 20	FROM B-5	FROM B-5	14	3-#6 @ 4' @ ENDS
B-5	10 x 20	2-#5	2-#7	6	4-#6 @ 5'

NOTES: TOP BARS SOLICED BY LAPPING 24 DIAS AT MIDSPAN B-3. BOTTOM BARS DOWN 10" AT NON-CONTINUOUS ENDS.

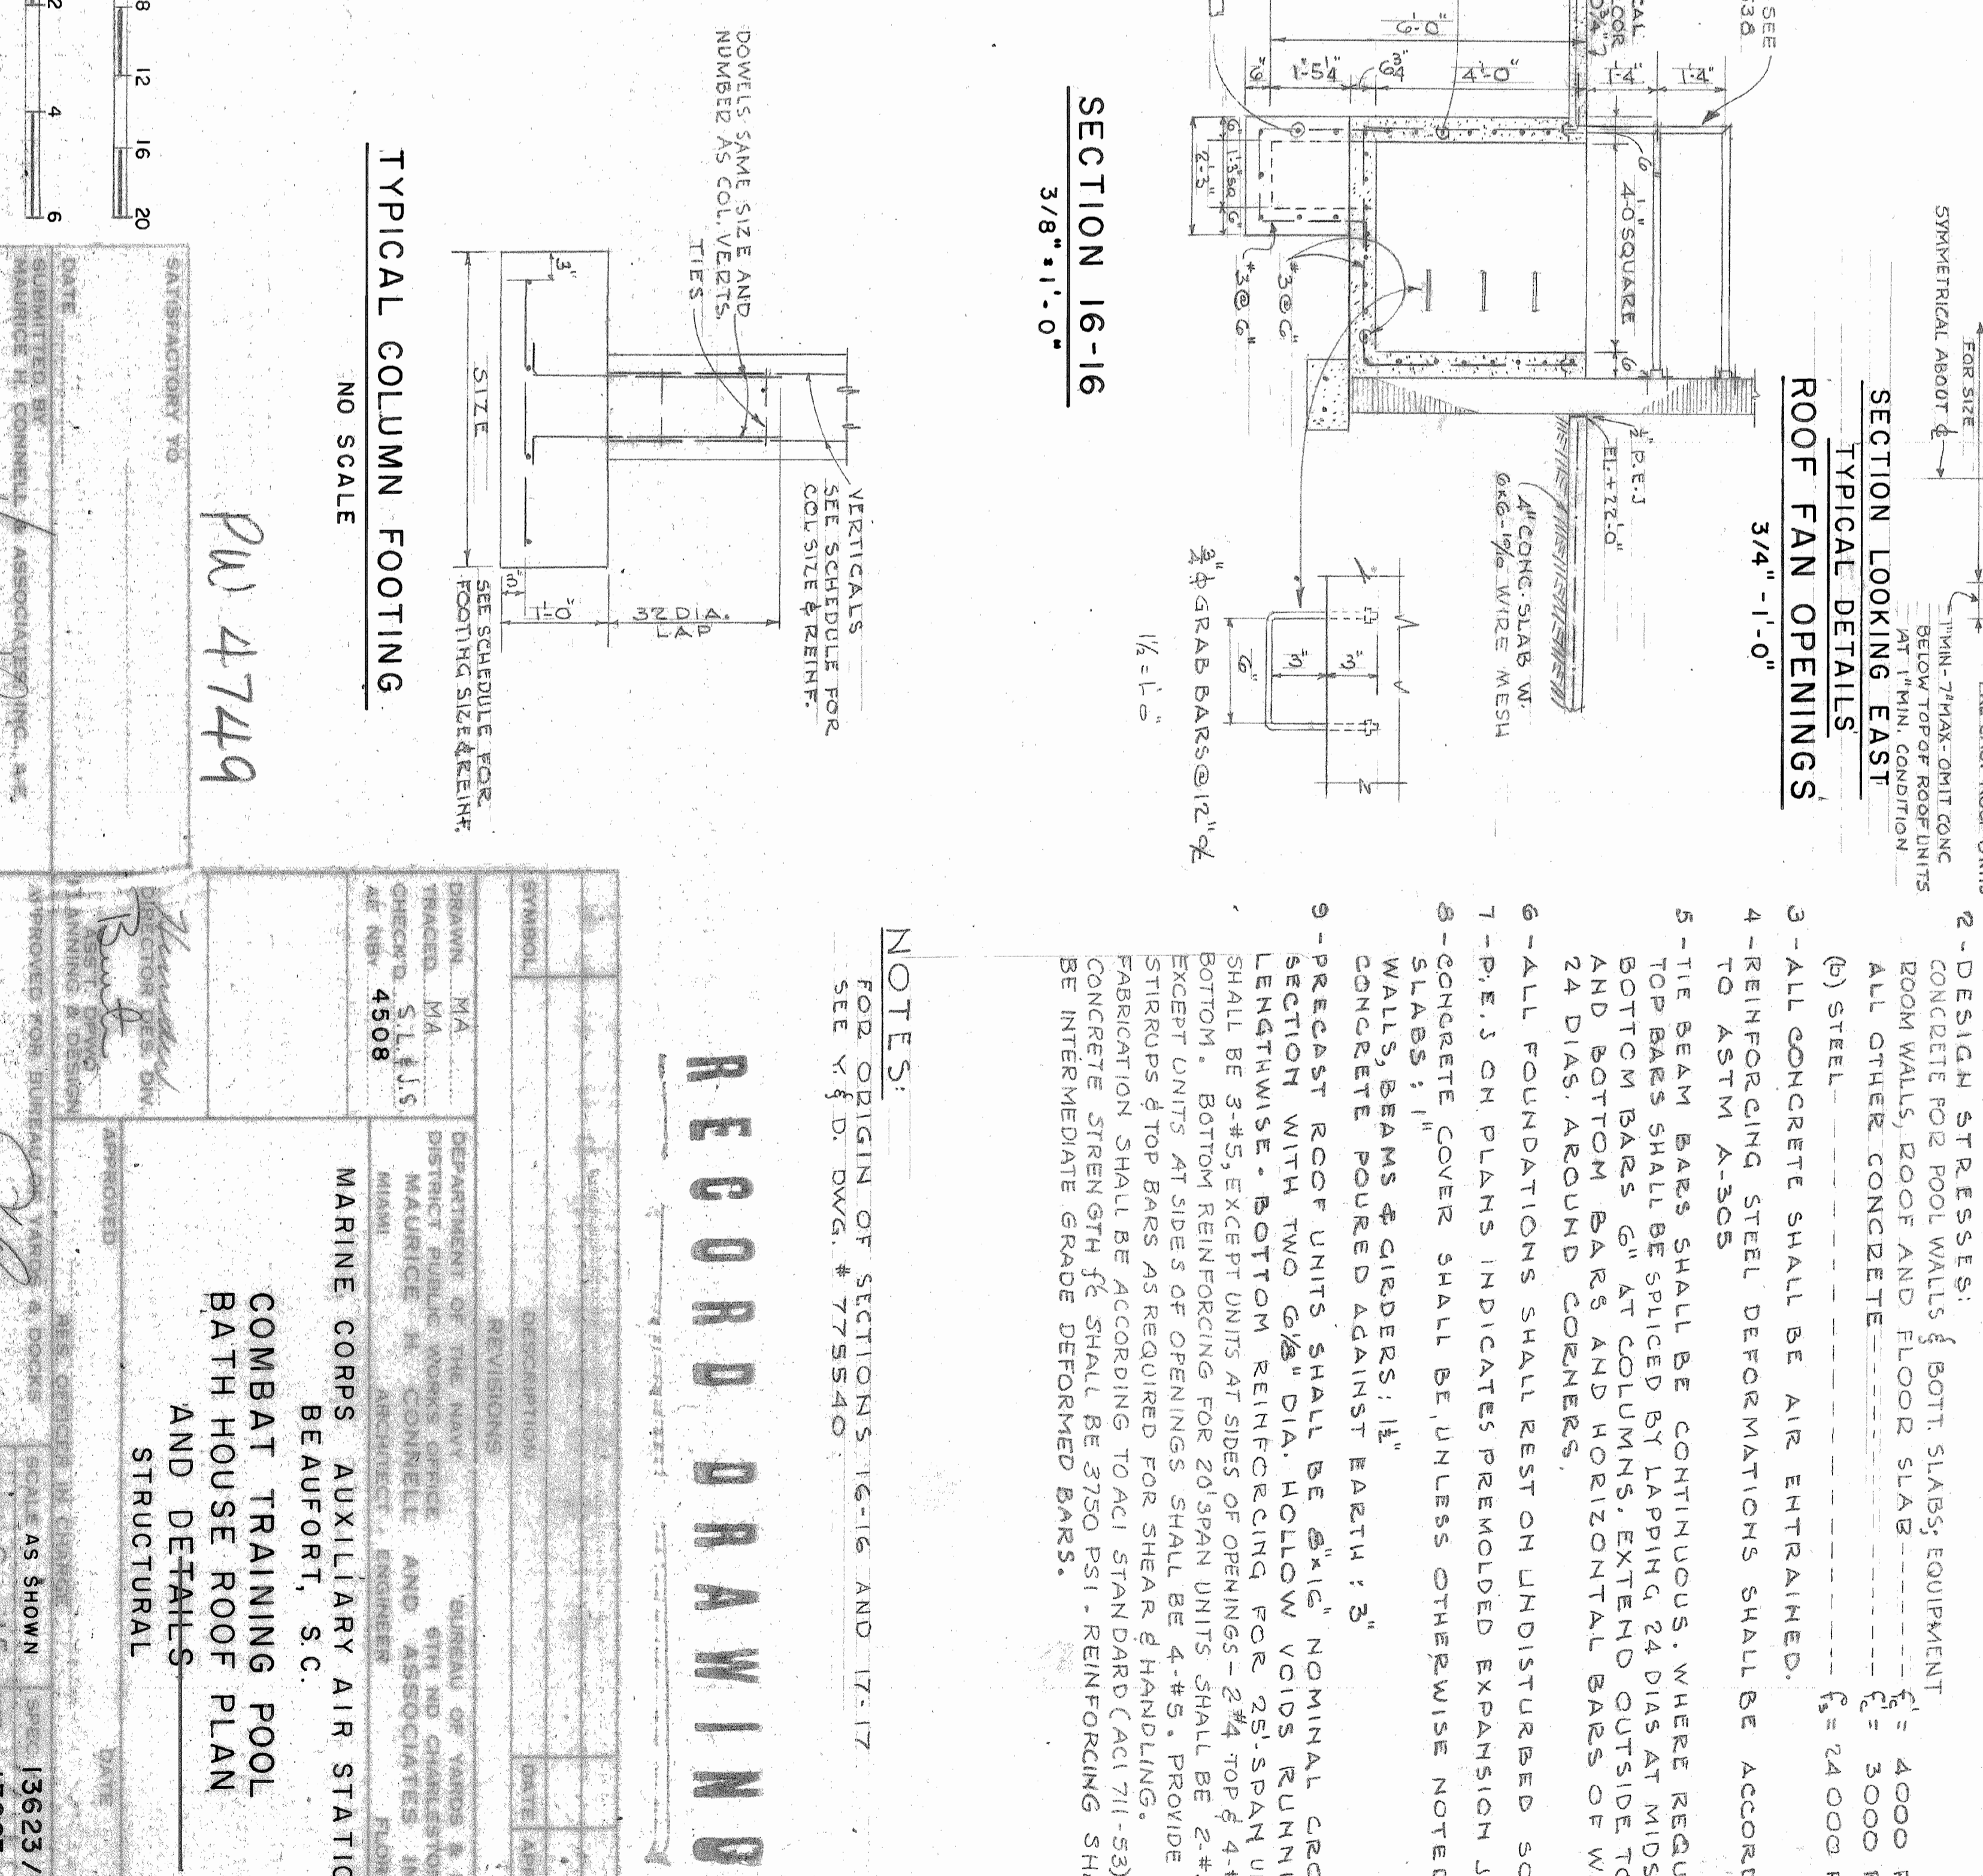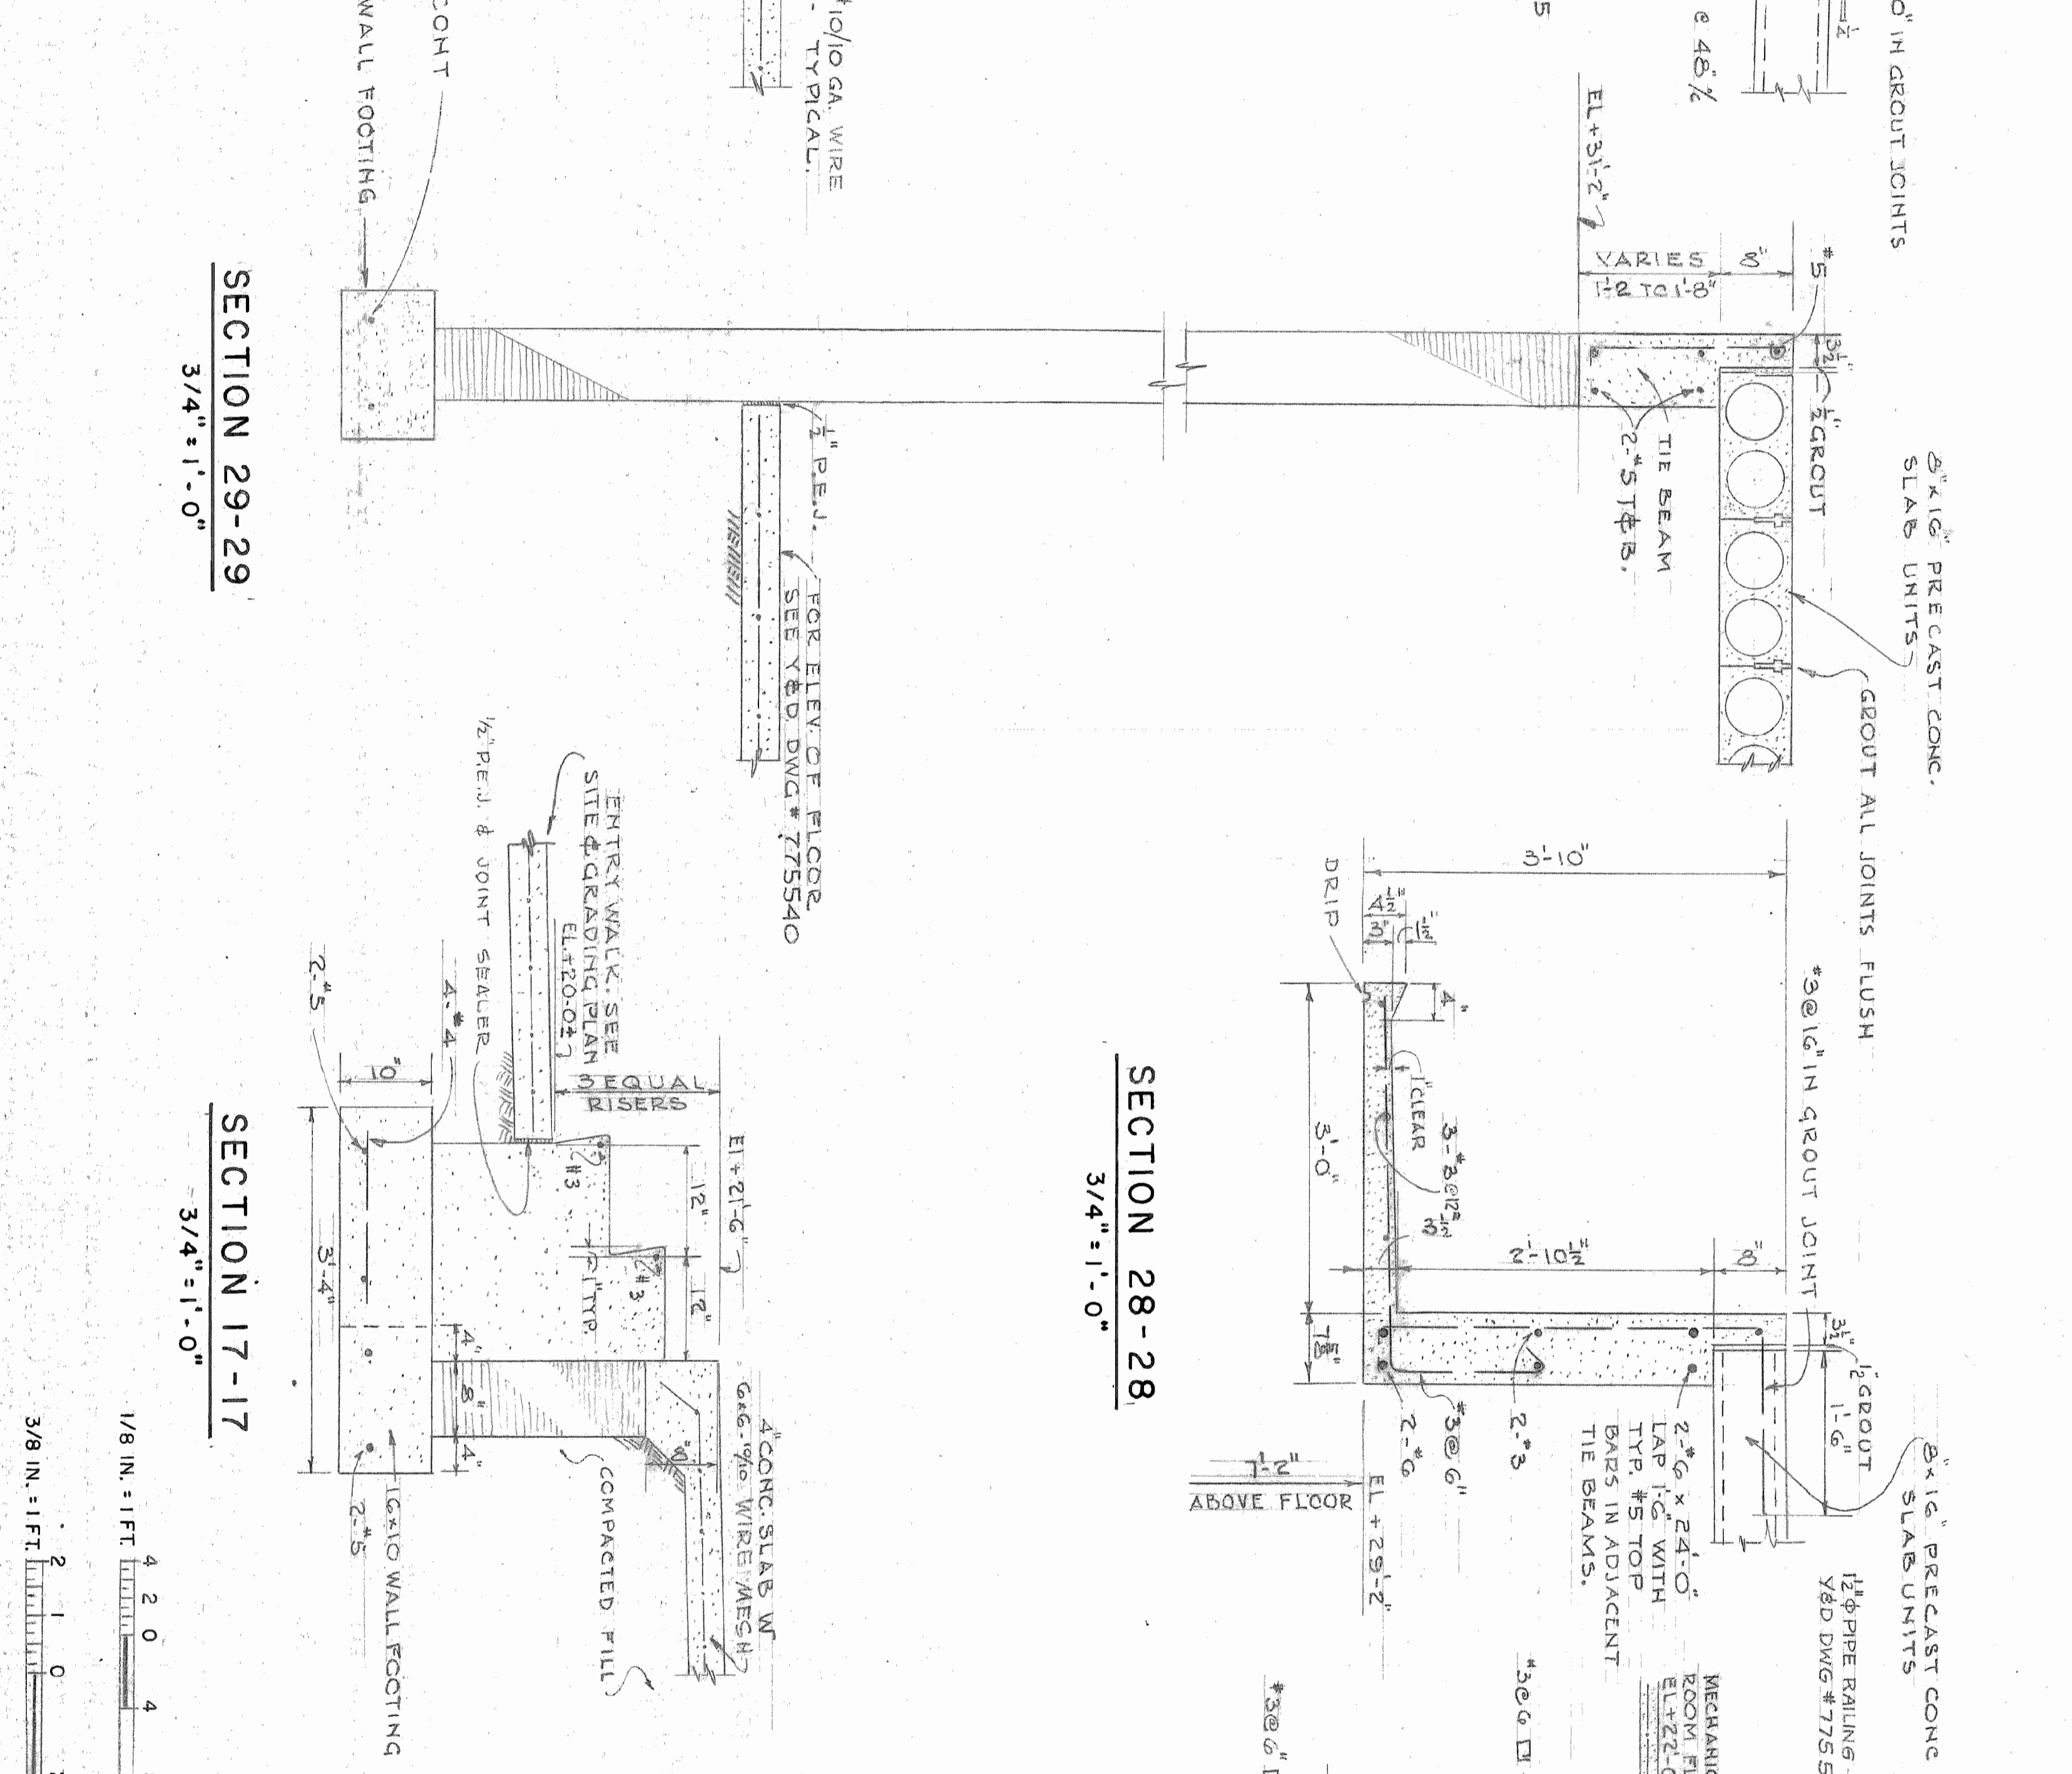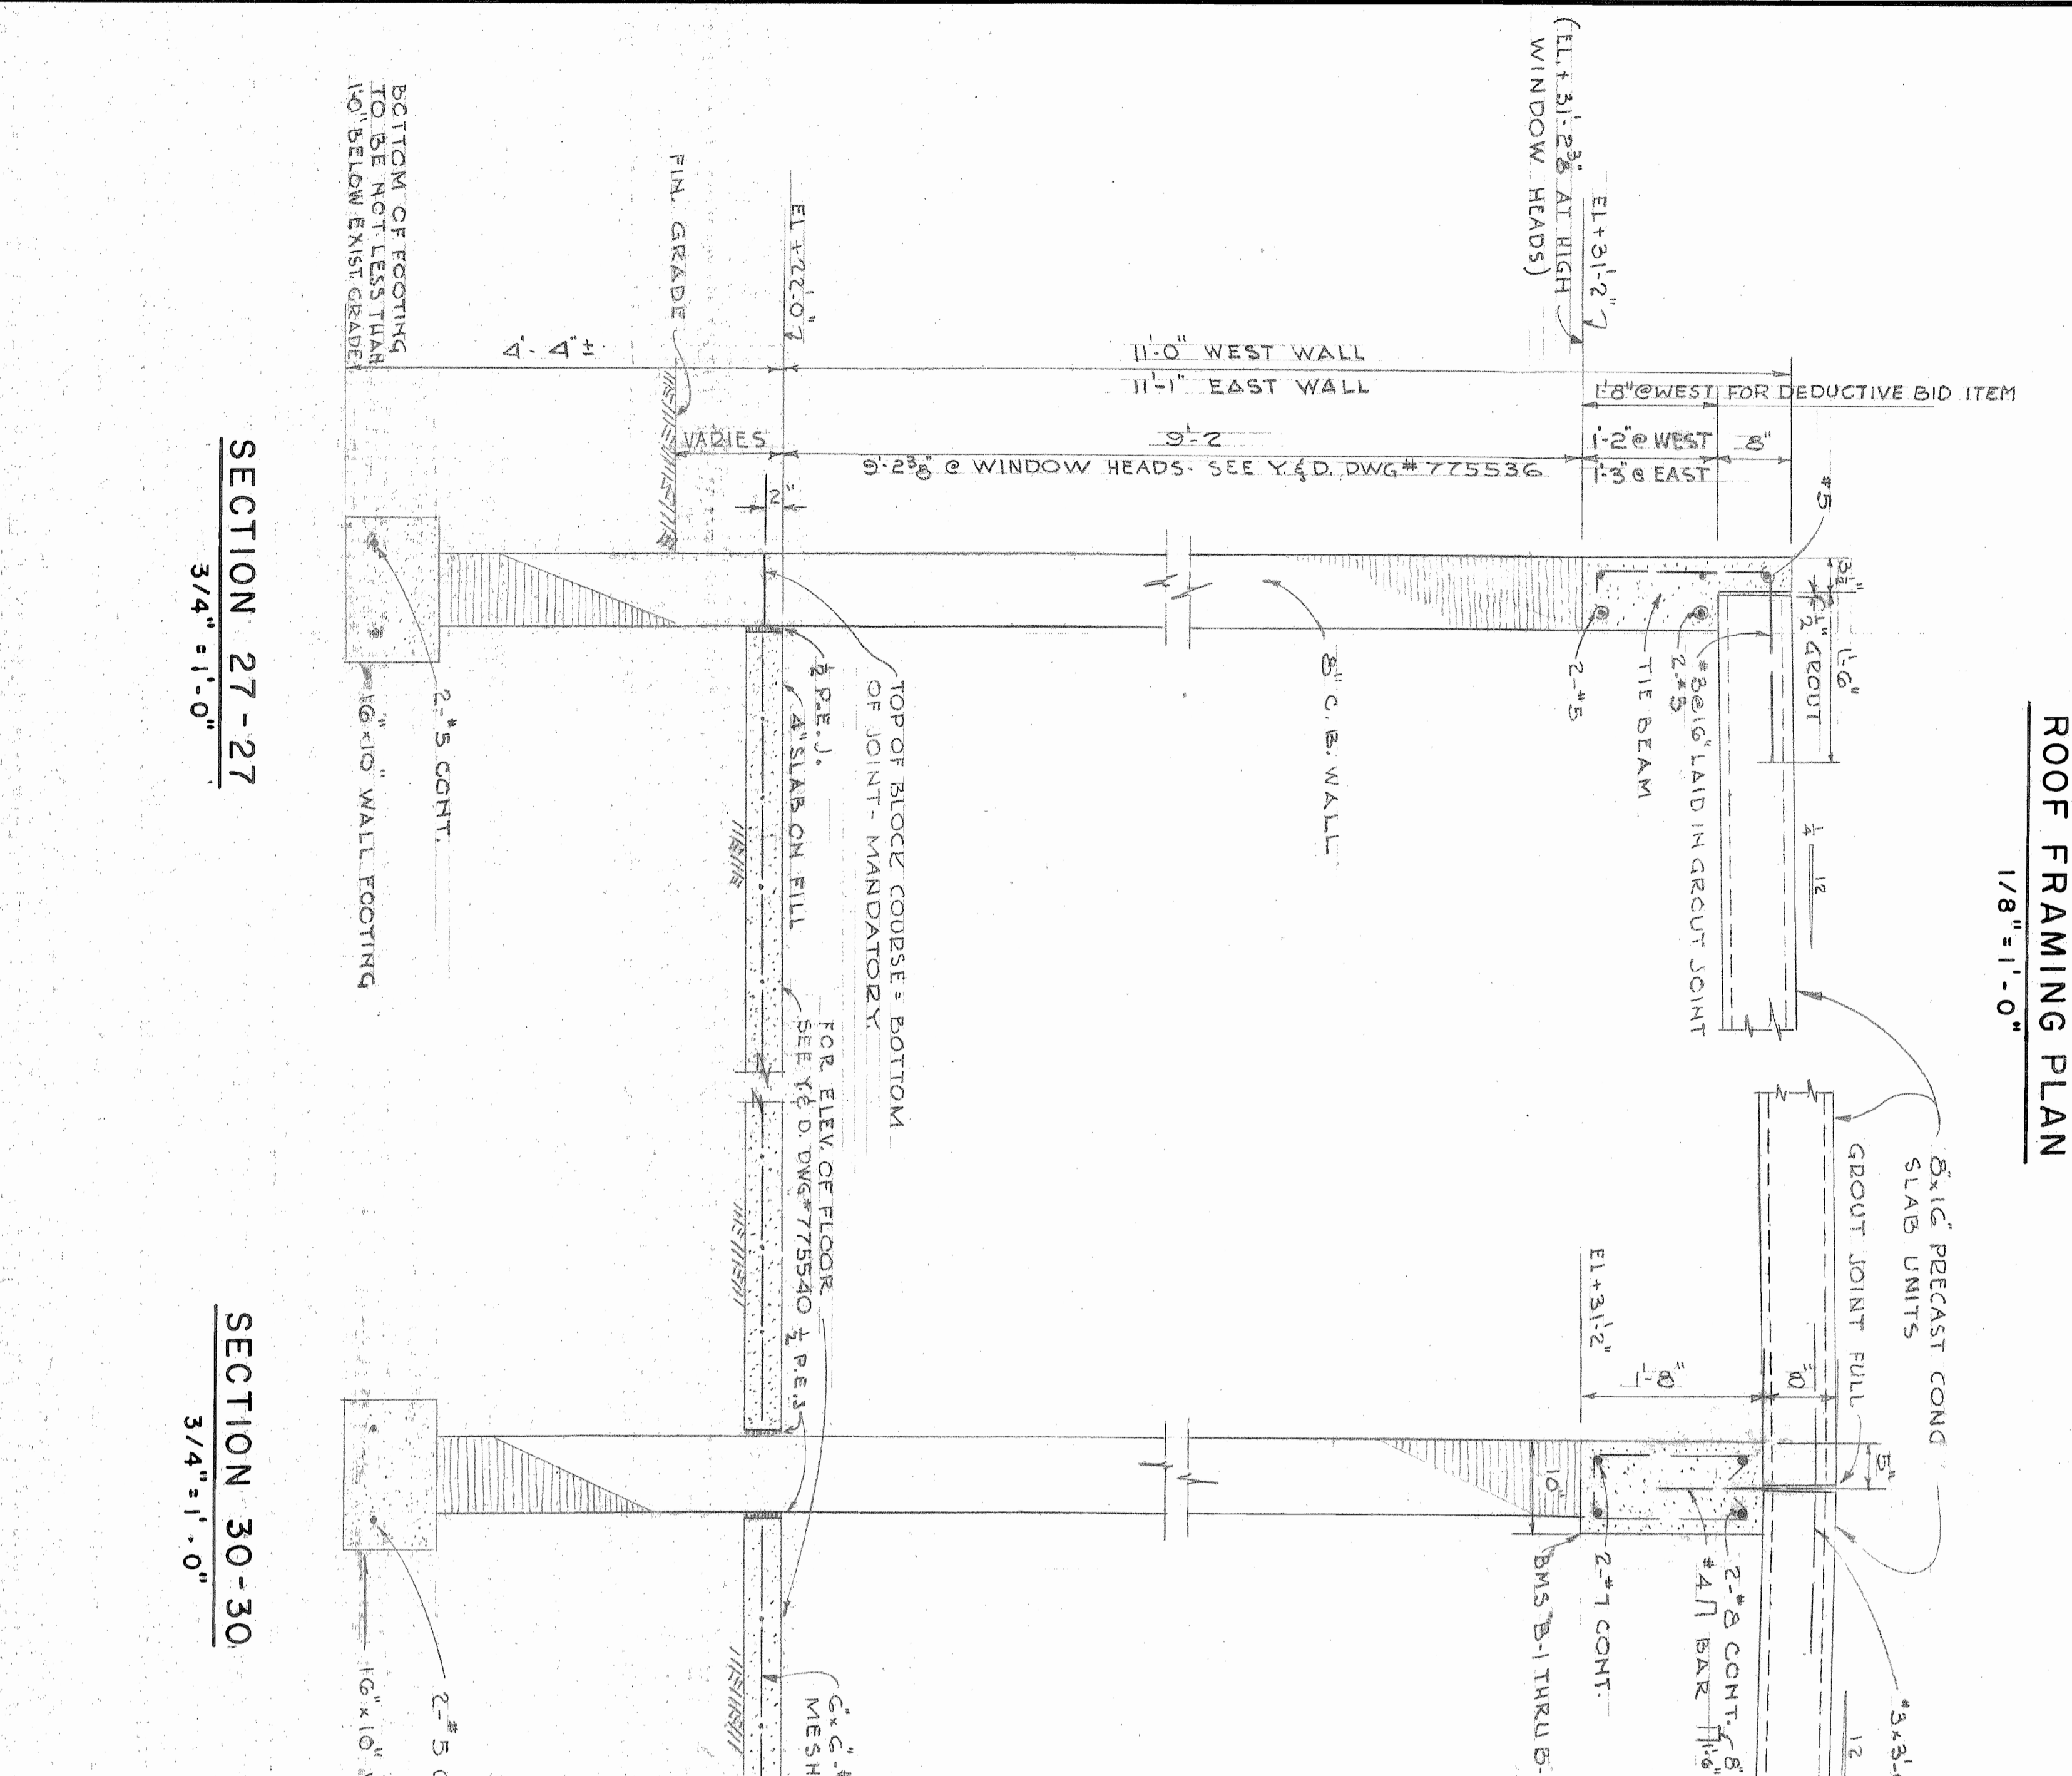

NOTES: FOR ORIGIN OF SECTIONS 16-16 AND 17-17 SEE Y & D DWG. # 775540.

RECORD DRAWING

DATE: 10/15/57
 DRAWN BY: J. W. ...
 CHECKED BY: ...
 APPROVED BY: ...
 MARINE CORPS AUXILIARY AIR STATION
 BEAUFORT, S.C.
 COMBAT TRAINING POOL
 BATH HOUSE ROOF PLAN
 AND DETAILS
 STRUCTURAL