

AMENDMENT OF SOLICITATION/MODIFICATION OF CONTRACT				1. CONTRACT ID CODE	PAGE 1 OF 3 PAGES
2. AMENDMENT/MODIFICATION NO. AMENDMENT NO. 0002		3. EFFECTIVE DATE 07/09/10	4. REQUISITION/PURCHASE REQ. NO.	5. PROJECT NO. (If applicable) 09-0205	
6. ISSUED BY CODE		CODE mks	7. ADMINISTERED BY (If other than Item 6) CODE See Item 6		
Officer in Charge of Construction MCI-East 1005 Michael Road Camp Lejeune, NC 28547-2521					
8. NAME AND ADDRESS OF CONTRACTOR (No., street, county, State and ZIP Code)				(X)	9A. AMENDMENT OF SOLICITATION NO. N40085-09-R-0205
				X	9B. DATED (SEE ITEM 11) 06/25/10
					10A. MODIFICATION OF CONTRACT/ORDER NO.
					10B. DATED (SEE ITEM 11)
CODE	FACILITY CODE				

11. THIS ITEM ONLY APPLIES TO AMENDMENTS OF SOLICITATIONS

The above numbered solicitation is amended as set forth in Item 14. The hour and date specified for receipt of Offers is extended, is not extended. Offers must acknowledge receipt of this amendment prior to the hour and date specified in the solicitation or as amended, by one of the following methods:
 (a) By completing items 8 and 15, and returning _____ copies of the amendment; (b) By acknowledging receipt of this amendment on each copy of the offer submitted; or (c) By separate letter or telegram which includes a reference to the solicitation and amendment numbers. FAILURE OF YOUR ACKNOWLEDGMENT TO BE RECEIVED AT THE PLACE DESIGNATED FOR THE RECEIPT OF OFFERS PRIOR TO THE HOUR AND DATE SPECIFIED MAY RESULT IN REJECTION OF YOUR OFFER. If by virtue of this amendment your desire to change an offer already submitted, such change may be made by telegram or letter, provided each telegram or letter makes reference to the solicitation and this amendment, and is received prior to the opening hour and date specified.

12. ACCOUNTING AND APPROPRIATION DATA (If required)

13. THIS ITEM ONLY APPLIES TO MODIFICATION OF CONTRACTS/ORDERS. IT MODIFIES THE CONTRACT/ORDER NO. AS DESCRIBED IN ITEM 14.

CHECK ONE	A. THIS CHANGE ORDER IS ISSUED PURSUANT TO: (Specify authority) THE CHANGES SET FORTH IN ITEM 14 ARE MADE IN THE CONTRACT ORDER NO. IN ITEM 10A.
	B. THE ABOVE NUMBERED CONTRACT/ORDER IS MODIFIED TO REFLECT THE ADMINISTRATIVE CHANGES (such as changes in paying office, appropriation date, etc.) SET FORTH IN ITEM 14, PURSUANT TO THE AUTHORITY OF FAR 43.103(b).
	C. THIS SUPPLEMENTAL AGREEMENT IS ENTERED INTO PURSUANT TO AUTHORITY OF:
	D. OTHER (Specify type of modification and authority)

E. IMPORTANT: Contractor is not, is required to sign this document and return _____ copies to the issuing office.

14. DESCRIPTION OF AMENDMENT/MODIFICATION (Organized by UCF section headings, including solicitation/contract subject matter where feasible.)

09-0205, Renovations of Galley, Building NH100

(CONTINUED)


Except as provided herein, all terms and conditions of the document referenced in Item 9A or 10A, as heretofore changed, remains unchanged and in full force and effect.

15A. NAME AND TITLE OF SIGNER (Type or print)		16A. NAME AND TITLE OF CONTRACTING OFFICER (Type or print)	
15B. CONTRACTOR/OFFEROR		16B. UNITED STATES OF AMERICA	
15C. DATE SIGNED		16C. DATE SIGNED	
(Signature of person authorized to sign)		(Signature of Contracting Officer)	


CONTINUATION SHEET

1. Question: On Drawing E-101 Keyed Note 2, 6, and 7 all make reference to the lighting circuits being routed to Electrical Equipment room 004. What is the location of the mentioned electrical equipment room for those panels?
1. Answer: Please see attachment which indicates the panel locations referred to in keyed notes 2, 6, and 7.
2. Question: On Drawing E-102 Keyed Note 5 references the relocation of BEMCC10. What is the preferred Conduit & Conductor size?
2. Answer: A riser diagram provided by the base indicates that existing feeders to BEMCC10 are #1/0, but no conduit size is given. Verify before extending existing circuit that the existing wire size meets NEC requirements for voltage drop (include the conductor length added for feeder extension). Upsize wire and conduit if necessary to meet all NEC requirements.
3. Question: Sheet E-102 and E-601: No power wiring is shown for 13 VAVs. Per mechanical schedules VAVs need 120V power source. Please clarify.
3. Answer: Provide 120 volt power circuits as required for VAVs from spare circuits in Panel BER3.
4. Question: RFP states there are 450 days to complete the project. Spec Section 01 11 00 "SUMMARY OF WORK" para. 1.2 implies there are only 301 days to complete the project. Which is correct? Please Clarify
4. Answer: The contractor shall have 180 days for delivery and setup of the trailers. Once the trailers are setup, the galley will be turned over to the contractor and they will have 270 days to perform the renovation. Once the renovation is complete the contractor shall have 60 days to remove the trailers and return the site to its original condition. The total contract duration will be 510 days.

NOTES:
 SHEET NOTES:
 1. THIS SHEET IS FOR REFERENCE ONLY.

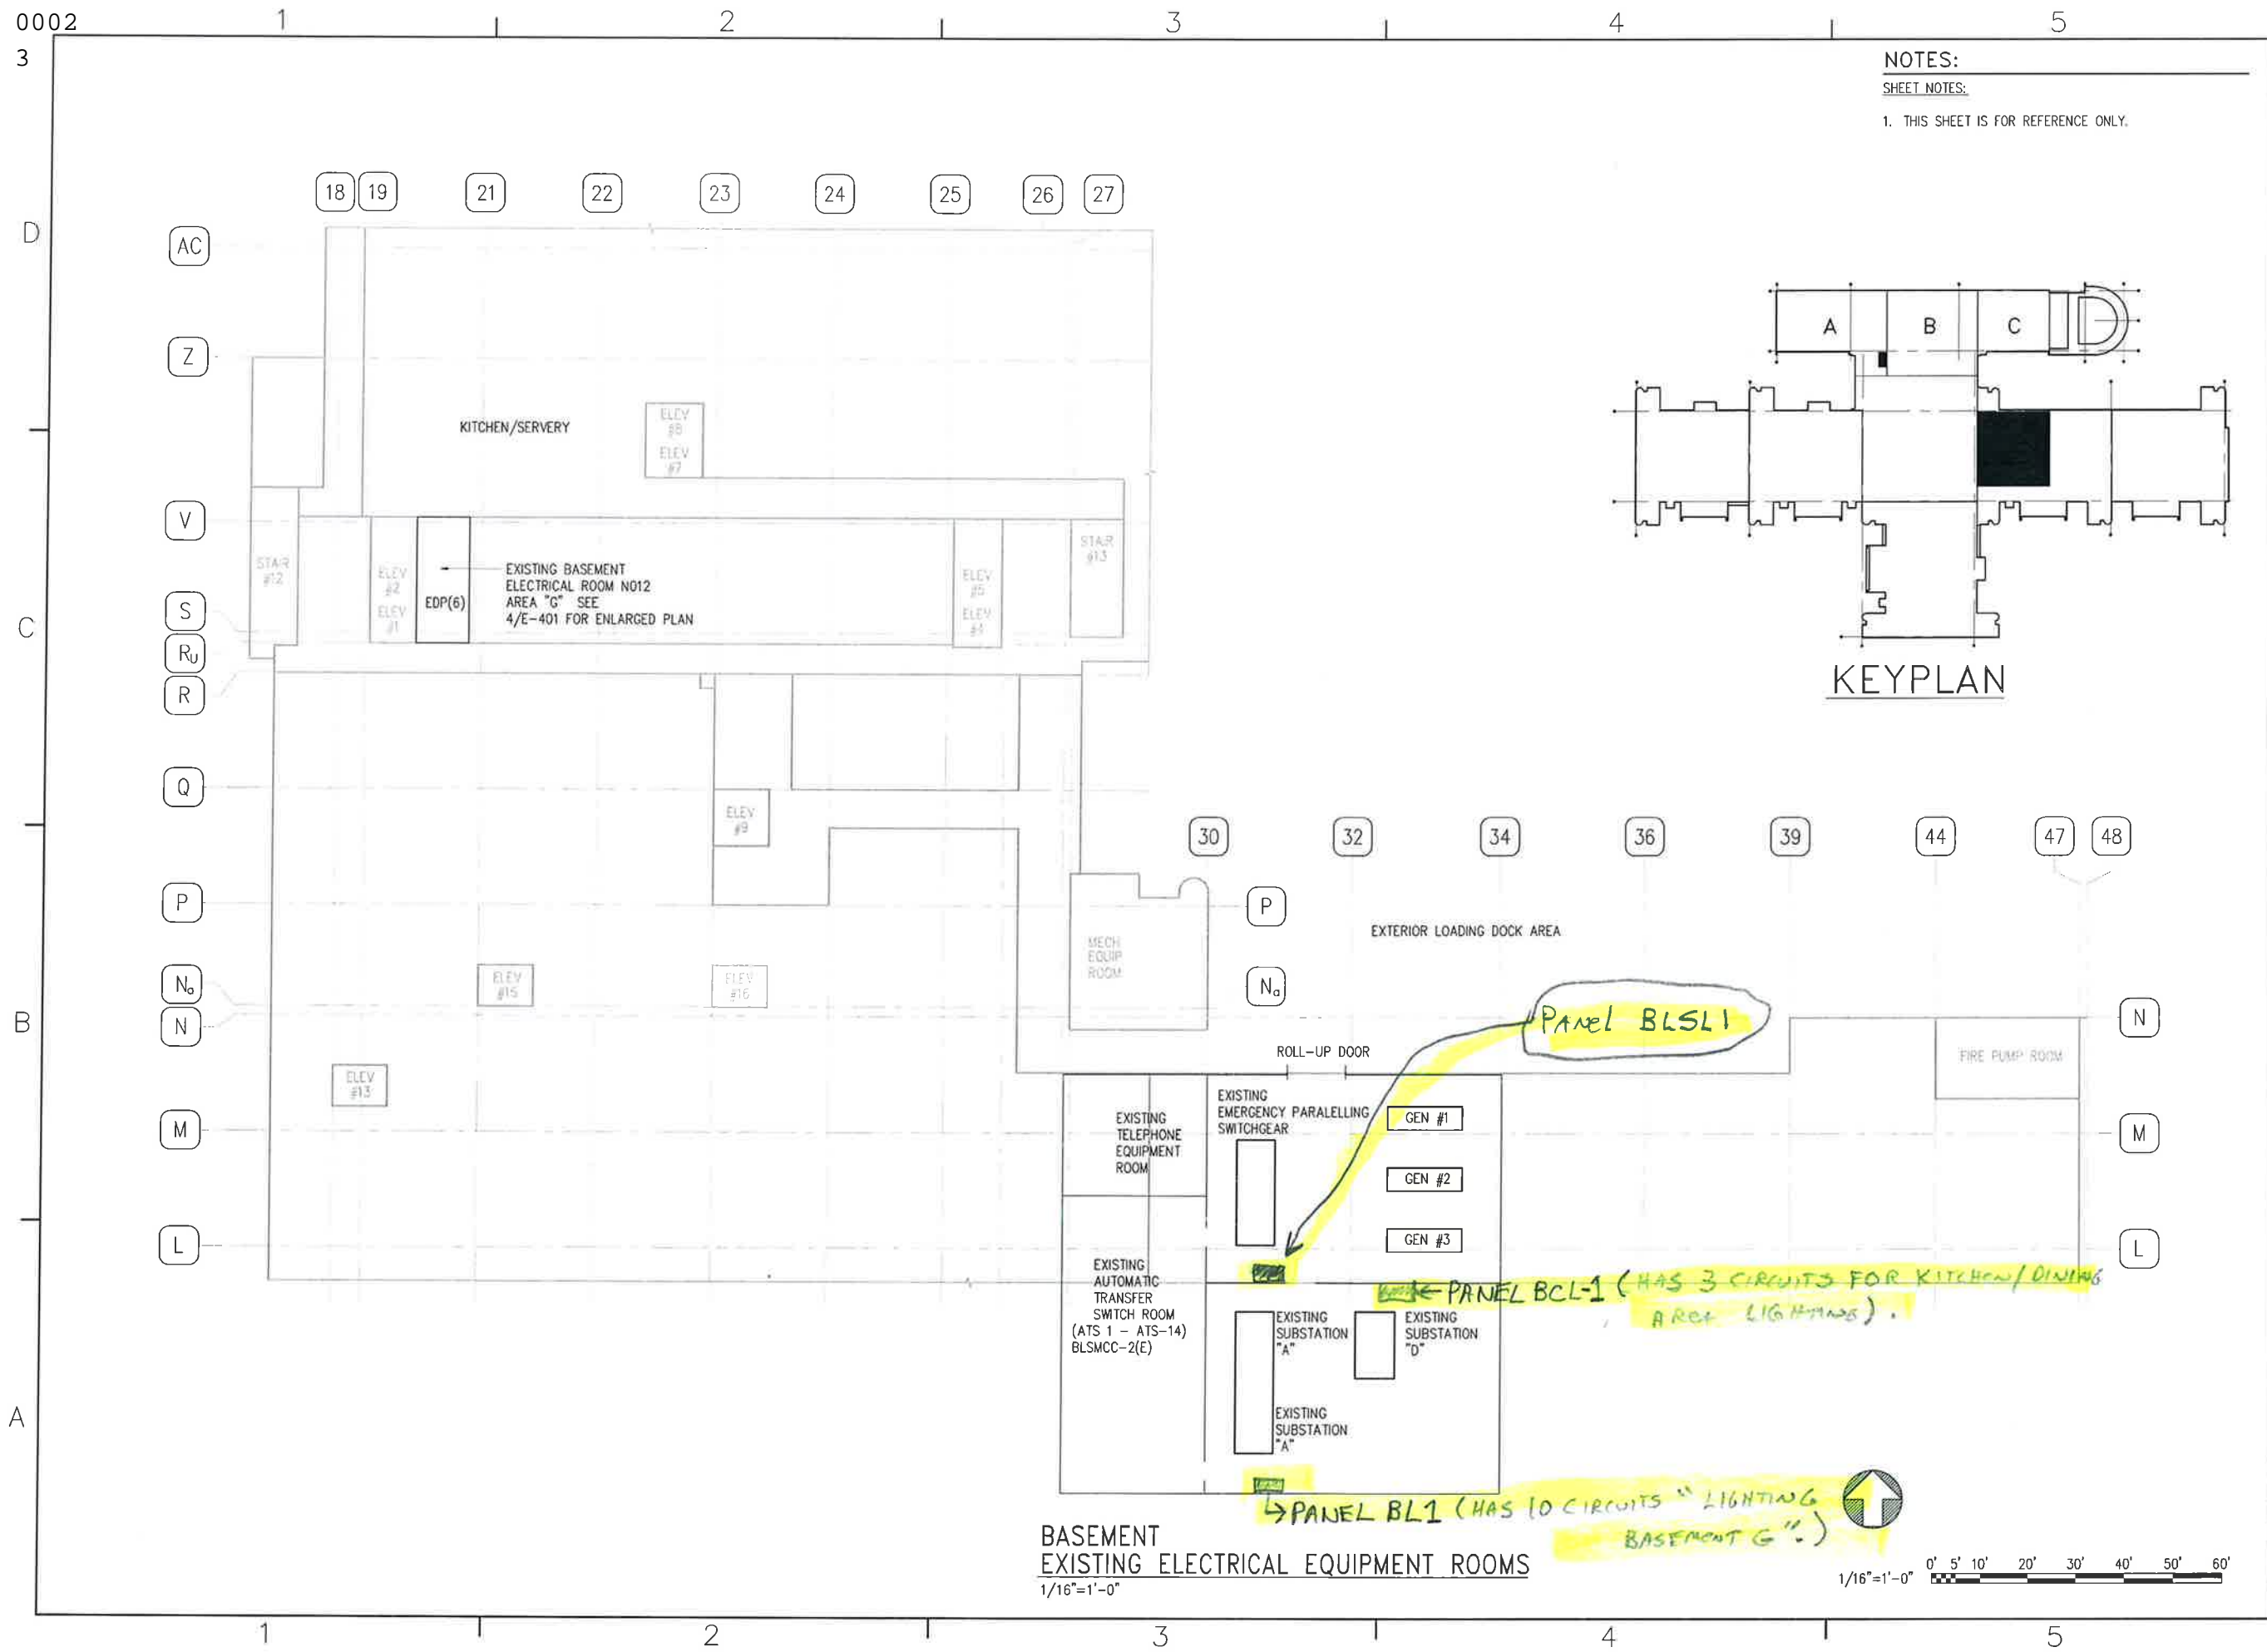

BASEMENT EXISTING ELECTRICAL EQUIPMENT ROOMS
 1/16"=1'-0"

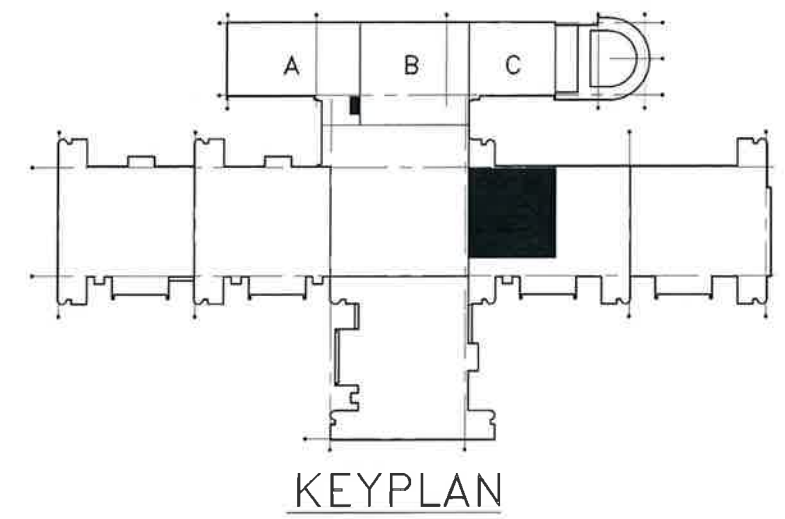

DATE	APPROVED
DESCRIPTION	SYN
 RLF ROGERS, LOVELOCK & FRITZ, INC. Architecture - Engineering - Interior Design 143 Leggett Avenue Water Park, Florida www.rlf.com LICENSE # AA 2200244 # 03 000029	
APPROVED	
ACTIVITY - SATISFACTORY TO	
DATE	
APPROVED	
 J.P. Bowen FOR EFD FOR COMMANDER NAVFAC 7/1/04	
DATE	
A/E	ED
SAP	DESIGN
SAP	DRAWN
KLM	REVIEW
SRA	DC
RWL	CHIEF ARCH/ENR.
PROJECT MANAGER	JTD
FIRE PROTECTION	HTC
BRANCH MANAGER	289
DESIGN DIRECTOR	
DEPARTMENT OF THE NAVY	NAVAL FACILITIES ENGINEERING COMMAND
NAVAL STATION	DIVISION
ATLANTIC	NORFOLK, VIRGINIA
NAVAL HOSPITAL	CAMP LEUEUNE, NORTH CAROLINA
HOSPITAL LDRP RENOVATION	BASEMENT ELECTRICAL EQUIPMENT ROOMS
CODE D. NO. 28001	SIZE D.
SCALE: 1/16" = 1'-0"	
EFD NO.	
STA. PROJ. NO. P-327	
SPEC. NO. 05-03-3001	
CONSTR. CONTR. NO.	
N62470-03-C-3001	
NAVFAC DRAWING NO.	
4521079	
SHEET 218 OF 249	
E-145	
<small>ORIGINATOR REVISION 5/27/2001</small>	